

Note:
THIS DRAWING HAS BEEN PREPARED ON RE-MAPPED OS DATA AND
REPLACES THE LATEST REVISION OF DRG NO. 482 CVM1A


FINAL APPROVED VERSION OF COMMUNAL LAND TRANSFER PLAN 29 JUNE 2015

Plan B



LEGEND

- Red line shows extent of Management Land
- hatched area to be responsibility of management
- each unit / plot is allocated a number
- each unit / plot has designated car parking space shown with corresponding number

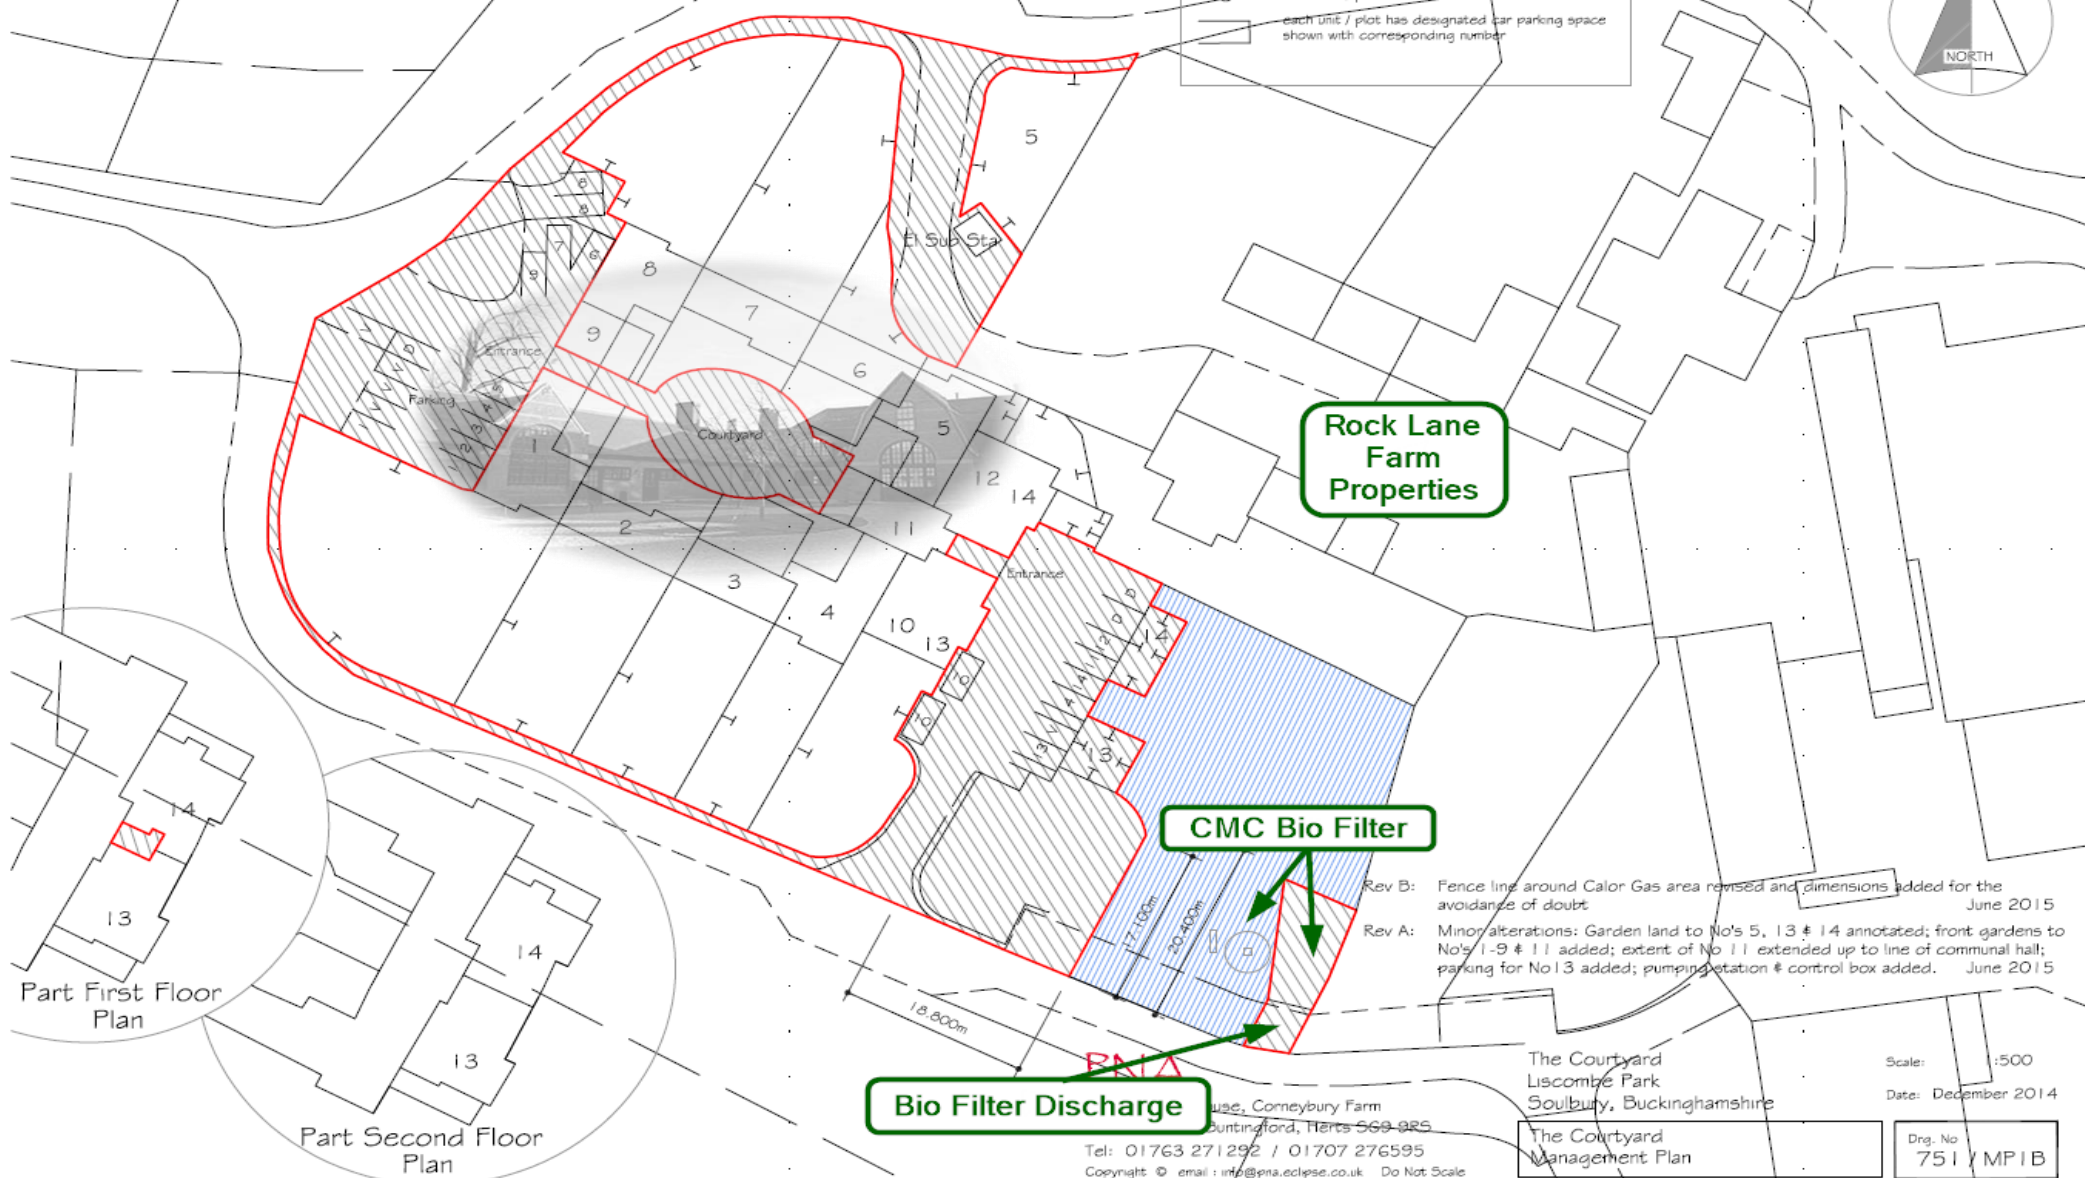

Rock Lane Farm Properties

CMC Bio Filter

Bio Filter Discharge

Rev B: Fence line around Calor Gas area revised and dimensions added for the avoidance of doubt June 2015
Rev A: Minor alterations: Garden land to No's 5, 13 & 14 annotated; front gardens to No's 1-9 & 11 added; extent of No 11 extended up to line of communal hall; parking for No 13 added; pumping station & control box added. June 2015

The Courtyard
Liscombe Park
Soulbury, Buckinghamshire
The Courtyard
Management Plan

Scale: 1:500
Date: December 2014

Dwg. No
751 / MP1B

use, Conneybury Farm
Sunningford, Herts SG9 9RS
Tel: 01763 271292 / 01707 276595
Copyright © email: info@cpna.eclipse.co.uk Do Not Scale